



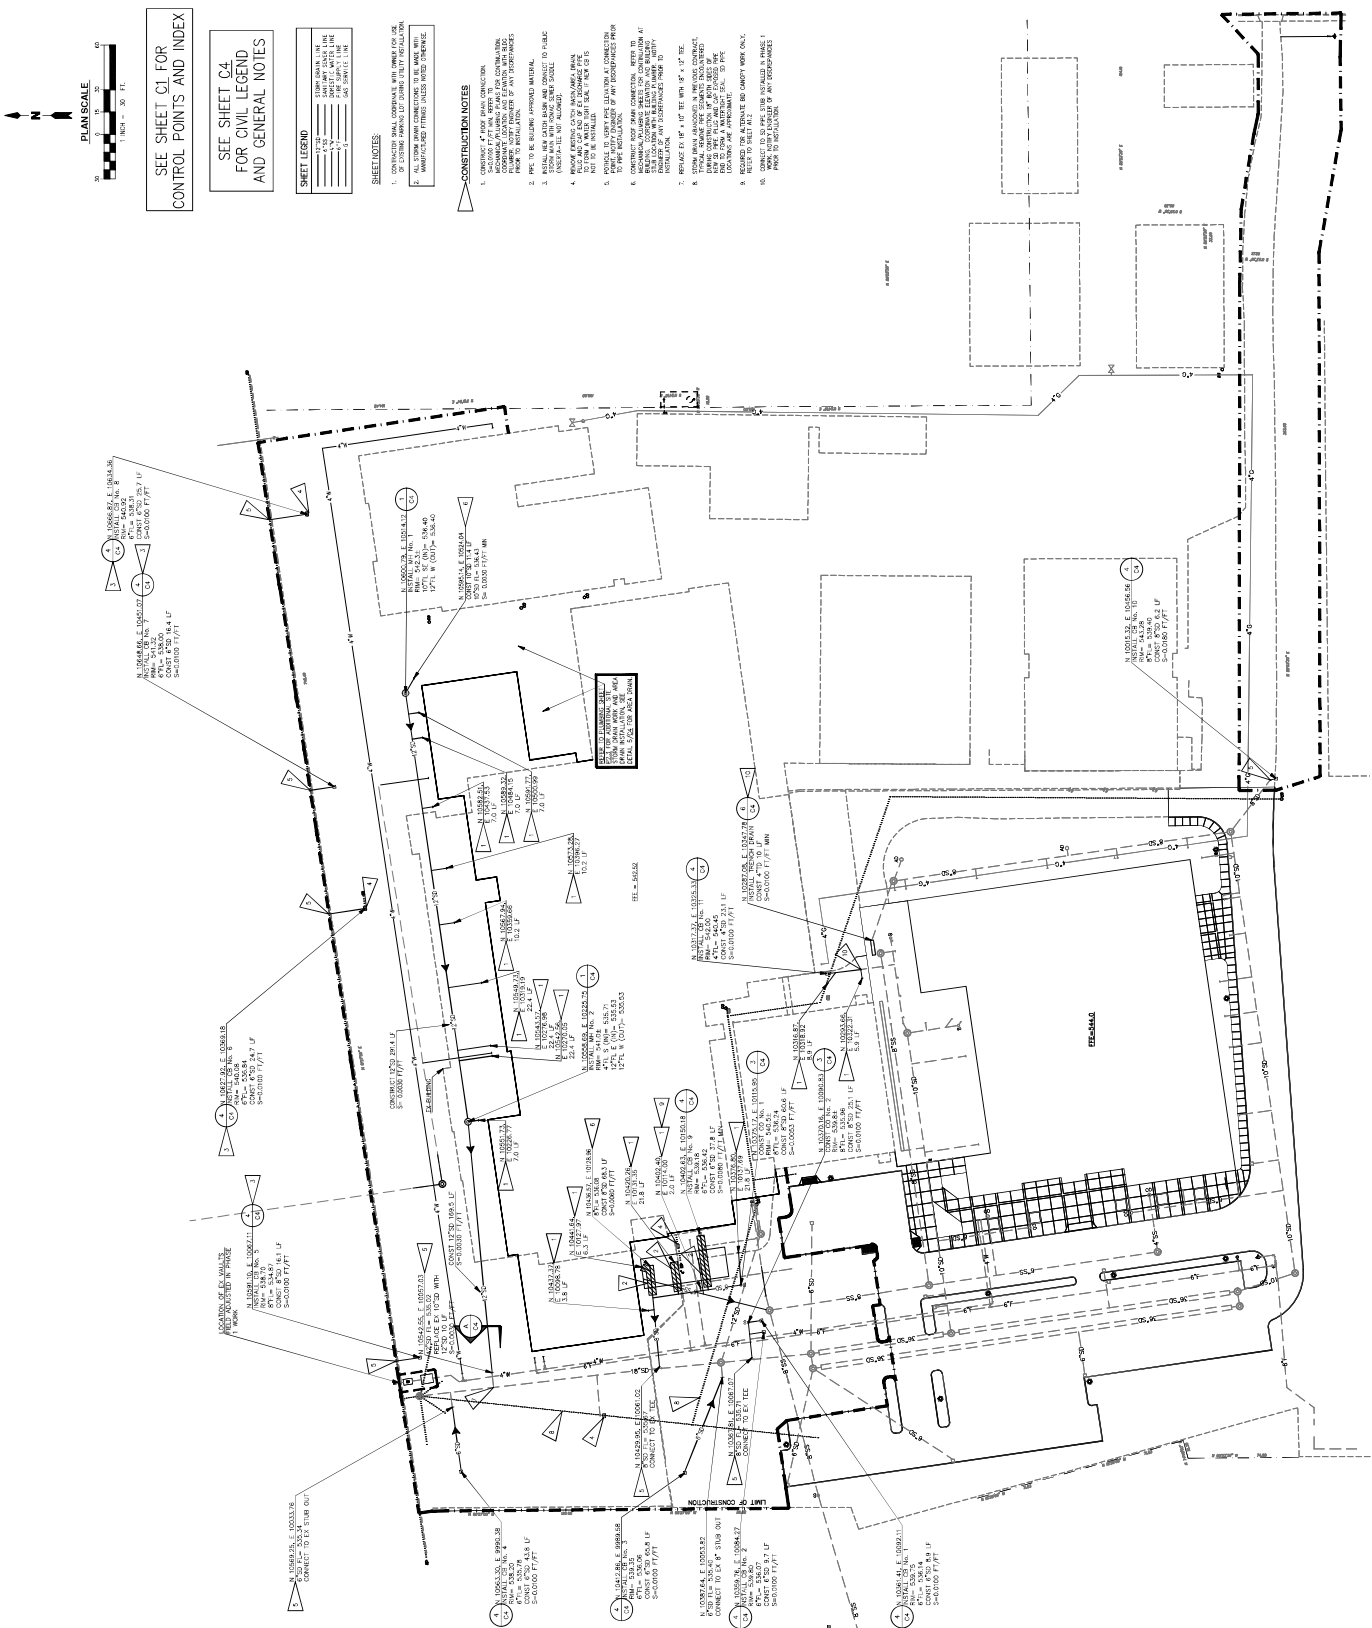


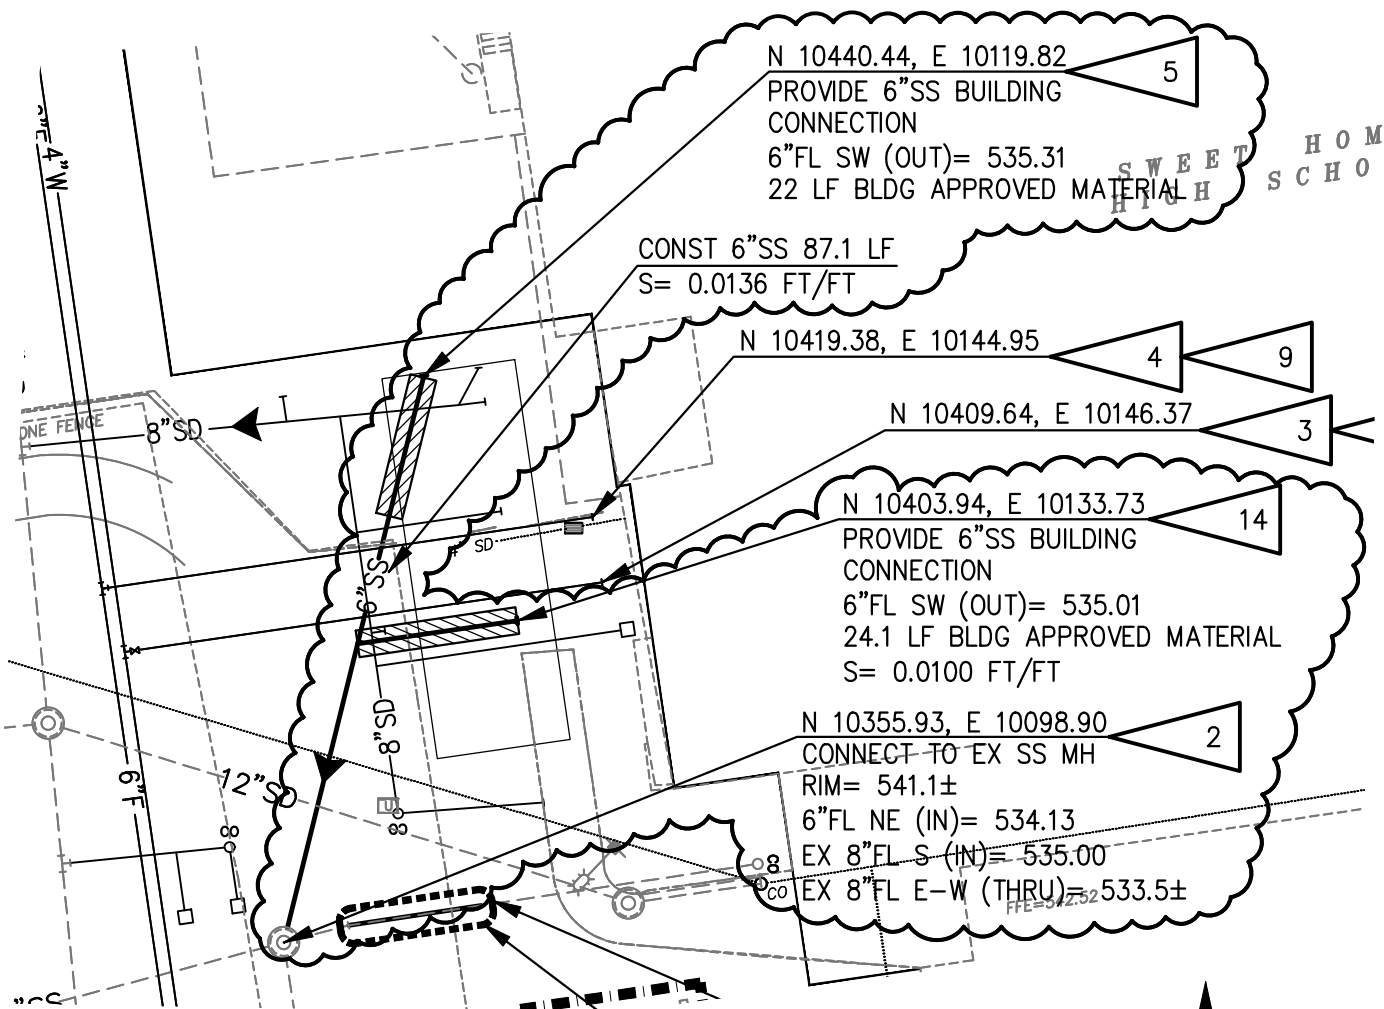

CONSTRUCTION NOTES

14. SWIMMING POOL BACKWASH DRAIN CONNECTION. COORDINATE BUILDING STUB LOCATION AND ELEVATION WITH BUILDING PLUMBER PRIOR TO INSTALLATION. IF EXISTING DRAIN CONNECTION IS FOUND, DISCONNECT FROM SD AND CONNECT TO SS AT THIS LOCATION WITH FLEX TRANSITION COUPLING.

PLAN SCALE

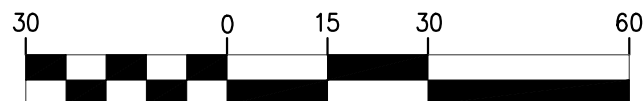

1 INCH = 30 FT.

PROJECT TITLE
SWEET HOME SCHOOL DISTRICT 55, 2001 BOND
HIGH SCHOOL RECONSTRUCTION

SHEET TITLE
SANITARY SEWER MODIFICATIONS

PROJECT NO:
420102

FILENAME:
420102/C3.dwg

DESIGNER:
BJR/MRA

DATE
09/22/03

SHEET NO

CSD-1

